


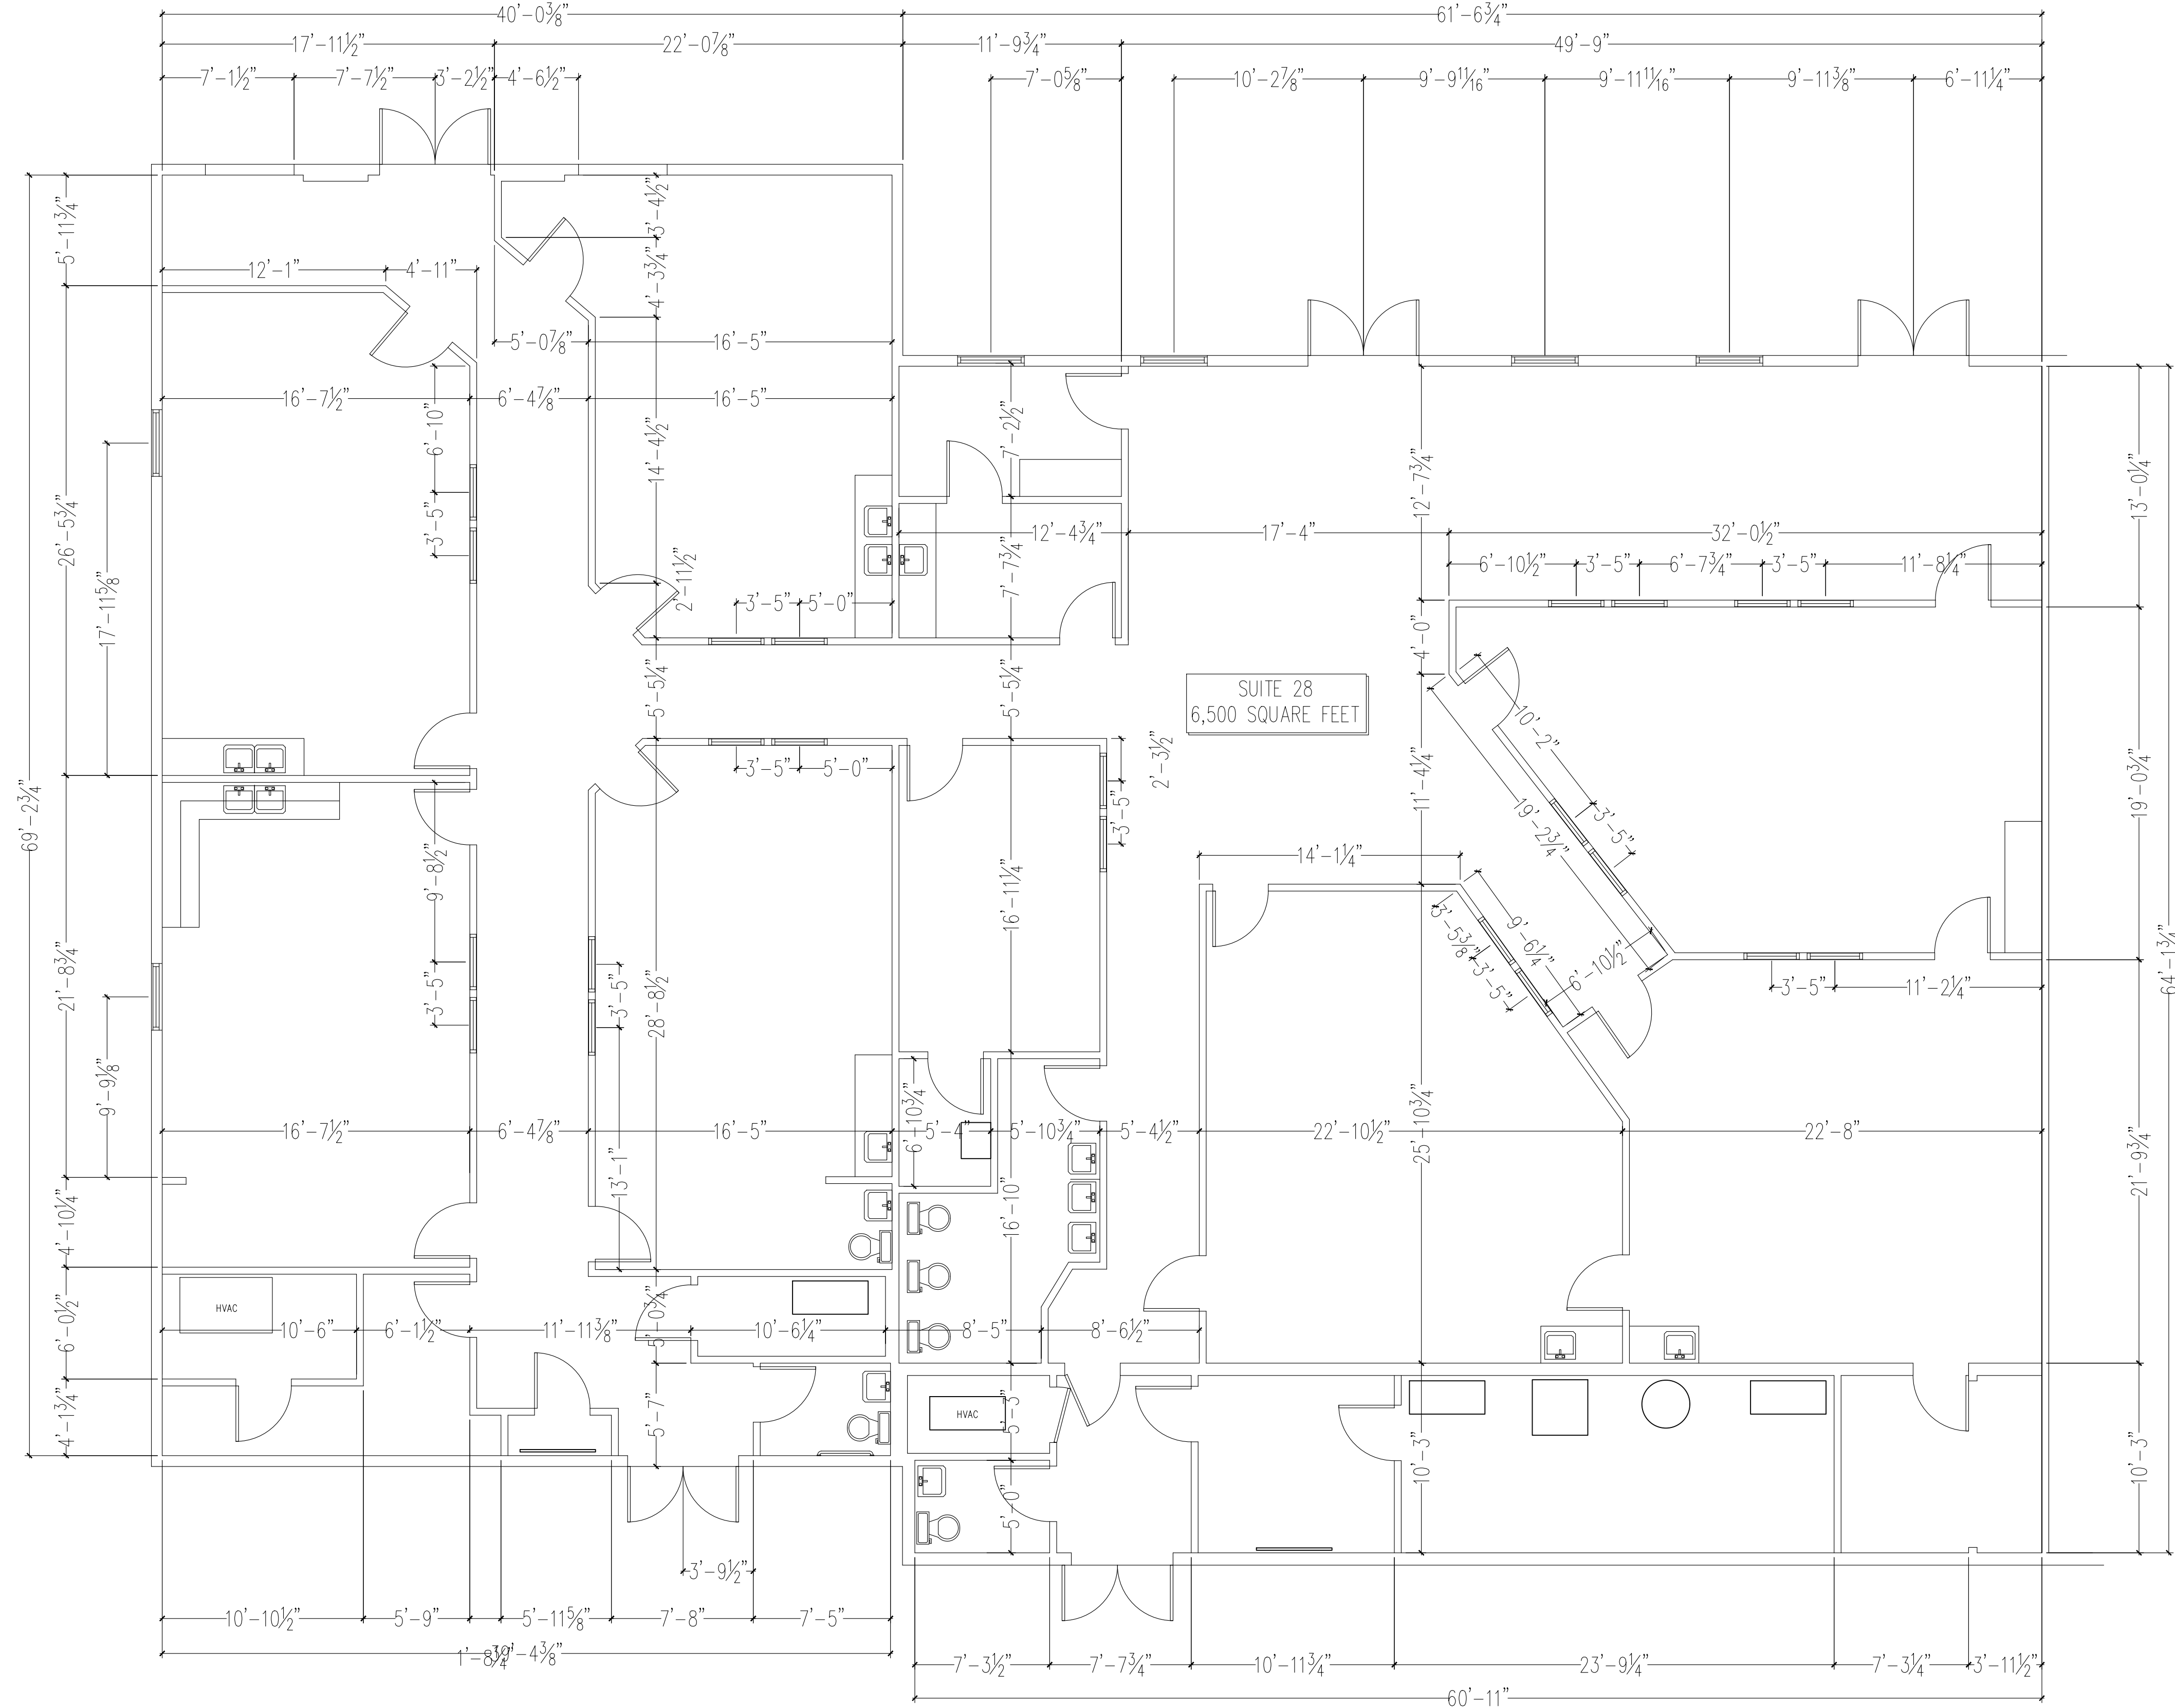

FLOOR PLAN
SCALE 3/16" = 1'-0"

DCG DEVELOPMENT
CLIFTON PARK NY

drawn by TOM MANOLEFF
518.588-2044

PROGRESS DRAWING

CONSTRUCTION DRAWING

reviewed and sealed by

SHEET

AS BUILT
9/14/2018

SUITE 28
MALTA COMMONS
MALTA, NEW YORK

PROJECT:

REV #	DATE
1	

A5
DRAWING NO

SCALE
AS SHOWN